



All measurements indicated are for guidance only

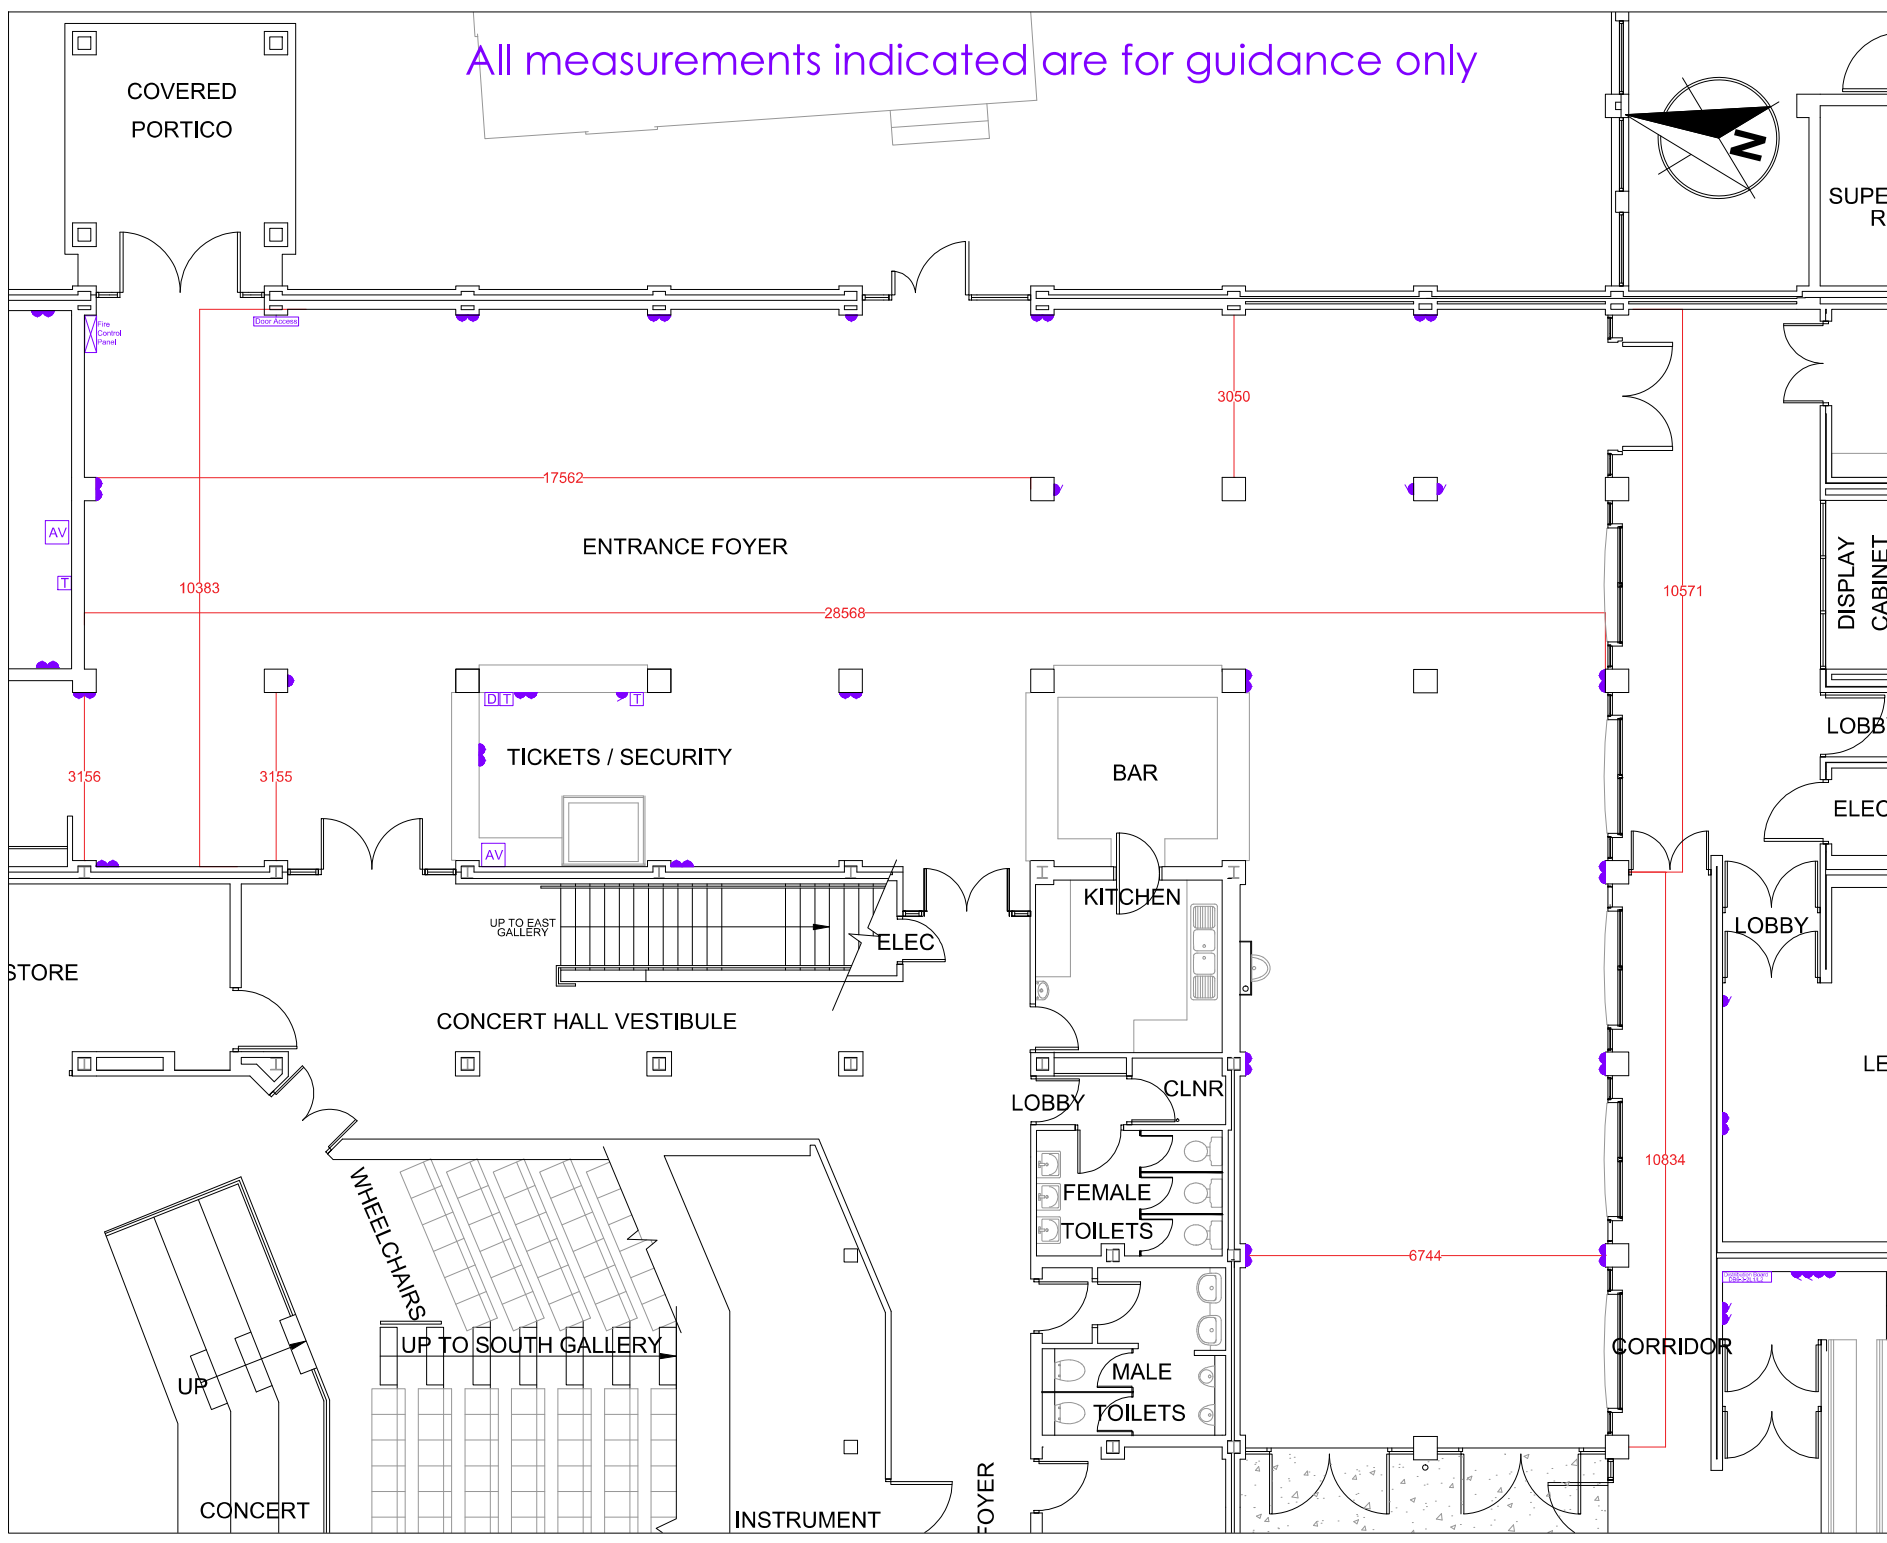

Date: 03/08/2017

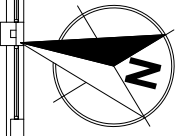

Consultant Drawing Reference

Site Location
 S049-Concert Hall
 00-Ground Floor
 S-Sidgwick Site

Drawing Description
 Ground Floor Plan
 MiCAD
 As Built

Document Status and Suitability Description

Revision	Revision Description	Scale @ A1
B		1:50

Project/Building	Originator	Volume	Level	Type	Role	Number
Concert Hall Drawings						