

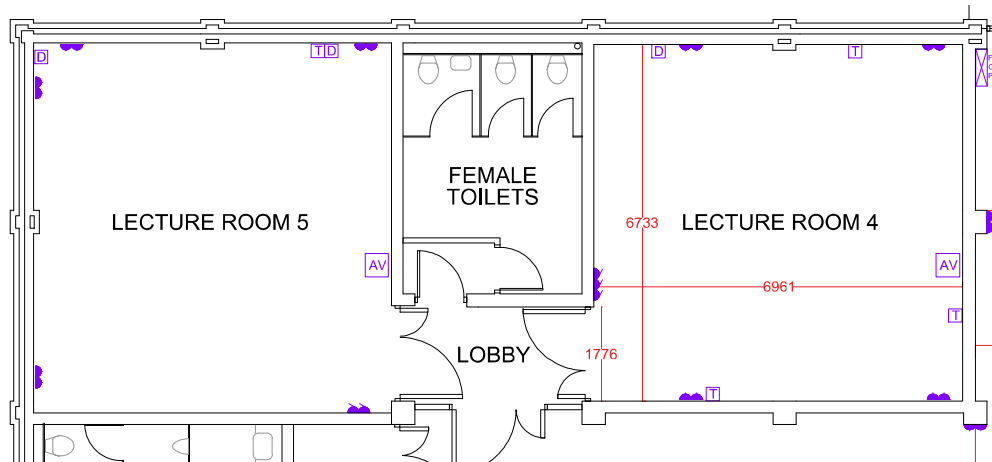
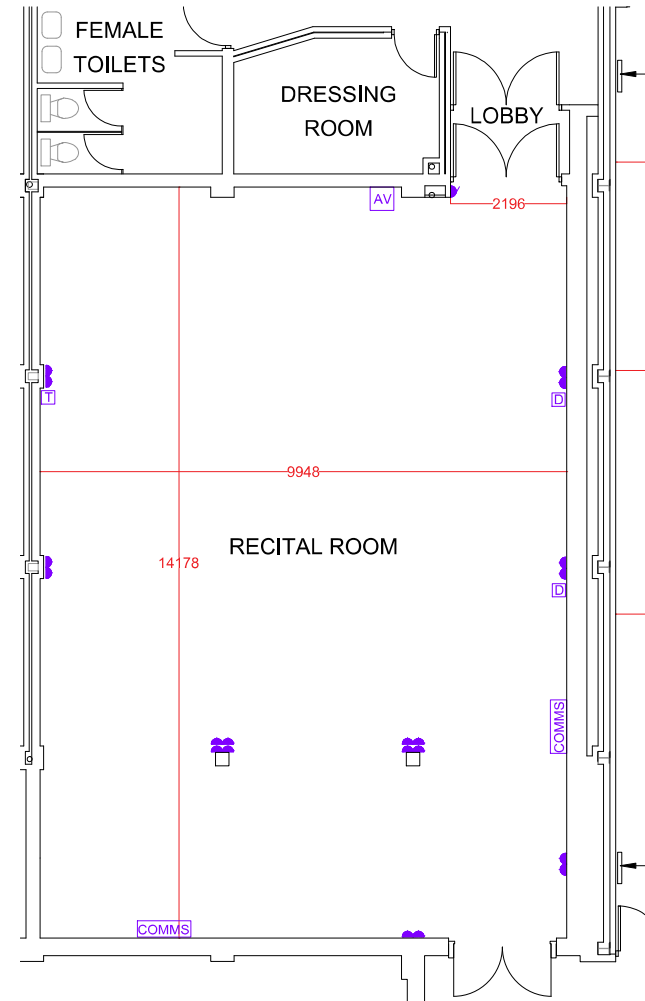
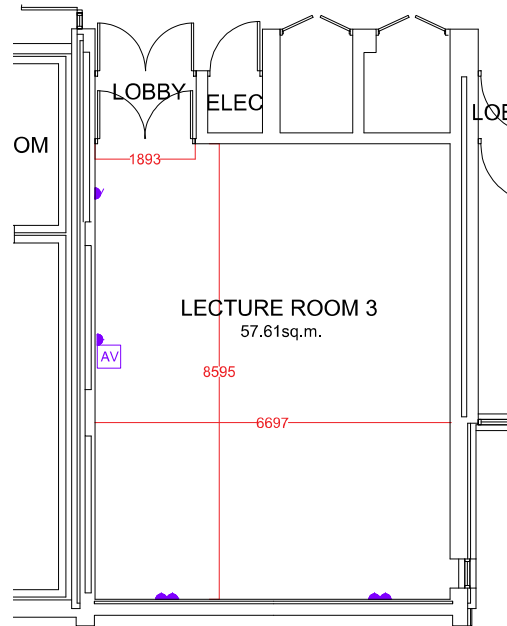


All measurements indicated are for guidance only

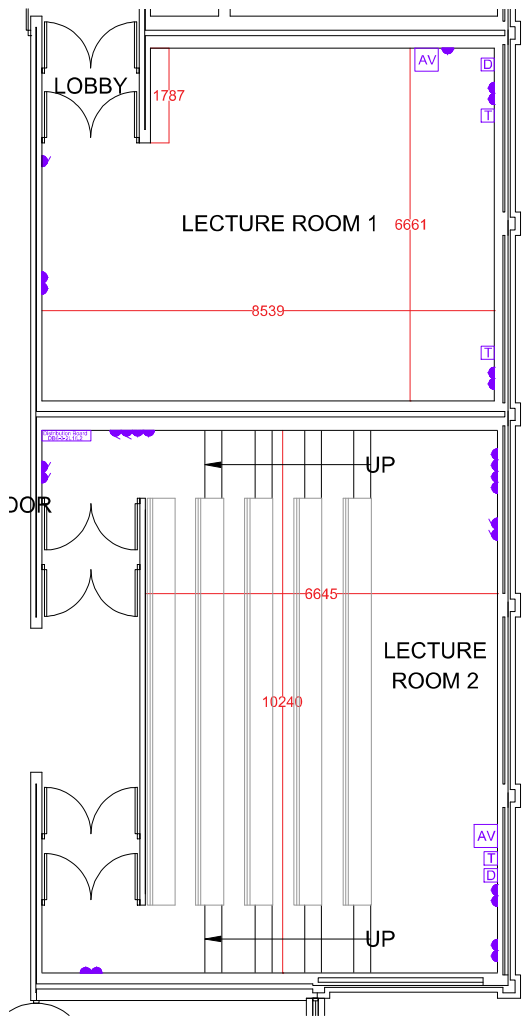

Date: 03/08/2017

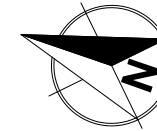

Consultant Drawing Reference

Site Location  
S049-Concert Hall  
00-Ground Floor  
S-Sidgwick Site

Drawing Description  
Ground Floor Plan  
iCAD  
As Built

Document Status and Suitability Description

Revision	Revision Description	Scale @ A1
B		1:50

Project/Building	Originator	Volume	Level	Type	Role	Number
Concert Hall Drawings						